

PHASE ONE

PHASE THREE



PHASE TWO

LEGEND

- DENOTES 200/150 SEWERLINE
- MH - DENOTES SEWER MANHOLE
- PB - DENOTES PILLAR BOXES
- DENOTES UNDER ELECTRICAL CABLE
- DENOTES Ø200mm WATER PIPE
- DENOTES Ø150mm WATER PIPE
- DENOTES Ø100mm WATER PIPE
- ◇ DENOTES DRIVEWAY
- ⊙ DENOTES SUMP PITS
- ⊙ DENOTES STREET LIGHT
- ⊙ DENOTES FIRE HYDRANT

<p>CADASTRALS CONSULTING SURVEYORS PLANNERS & PROJECT MANAGERS P. O. BOX 7555, LAUTOKA, PHONE : 6660988, 6660274 FAX 6662447 12 MALOLO STREET, Email : cadsurvey01@gmail.com</p>		<p>PROJECT PROPOSED SCHEME PLAN OF LOT 1 DP10316, VITOGO DRASA TAVAKUBU, LAUTOKA</p>	
<p>PRINCIPAL CONSULTANTS WesEng Consulting Limited CONSULTING CIVIL, STRUCTURAL, ENGINEERS, ENVIRONMENTAL ENGINEERS & PROJECT MANAGERS & GEOTECHNICAL INVESTIGATIONS & TESTING 2 Tui Street, Level 2, A.C. Group Bldg Lautoka P.O. Box 455 Lautoka, Phone 6660557 Fax 6660444 Mobile 999597 Email: weseng@comnet.com.fj</p>	<p>CAD/2148 (2018-REV-07) SCALE: 1: 2000 No.17 A1</p>	<p>ACLT : C/2100-2299/2148-COMBINE DETAILS</p>	

TAVAKUBU ASBUILT PHASE 1 & 2

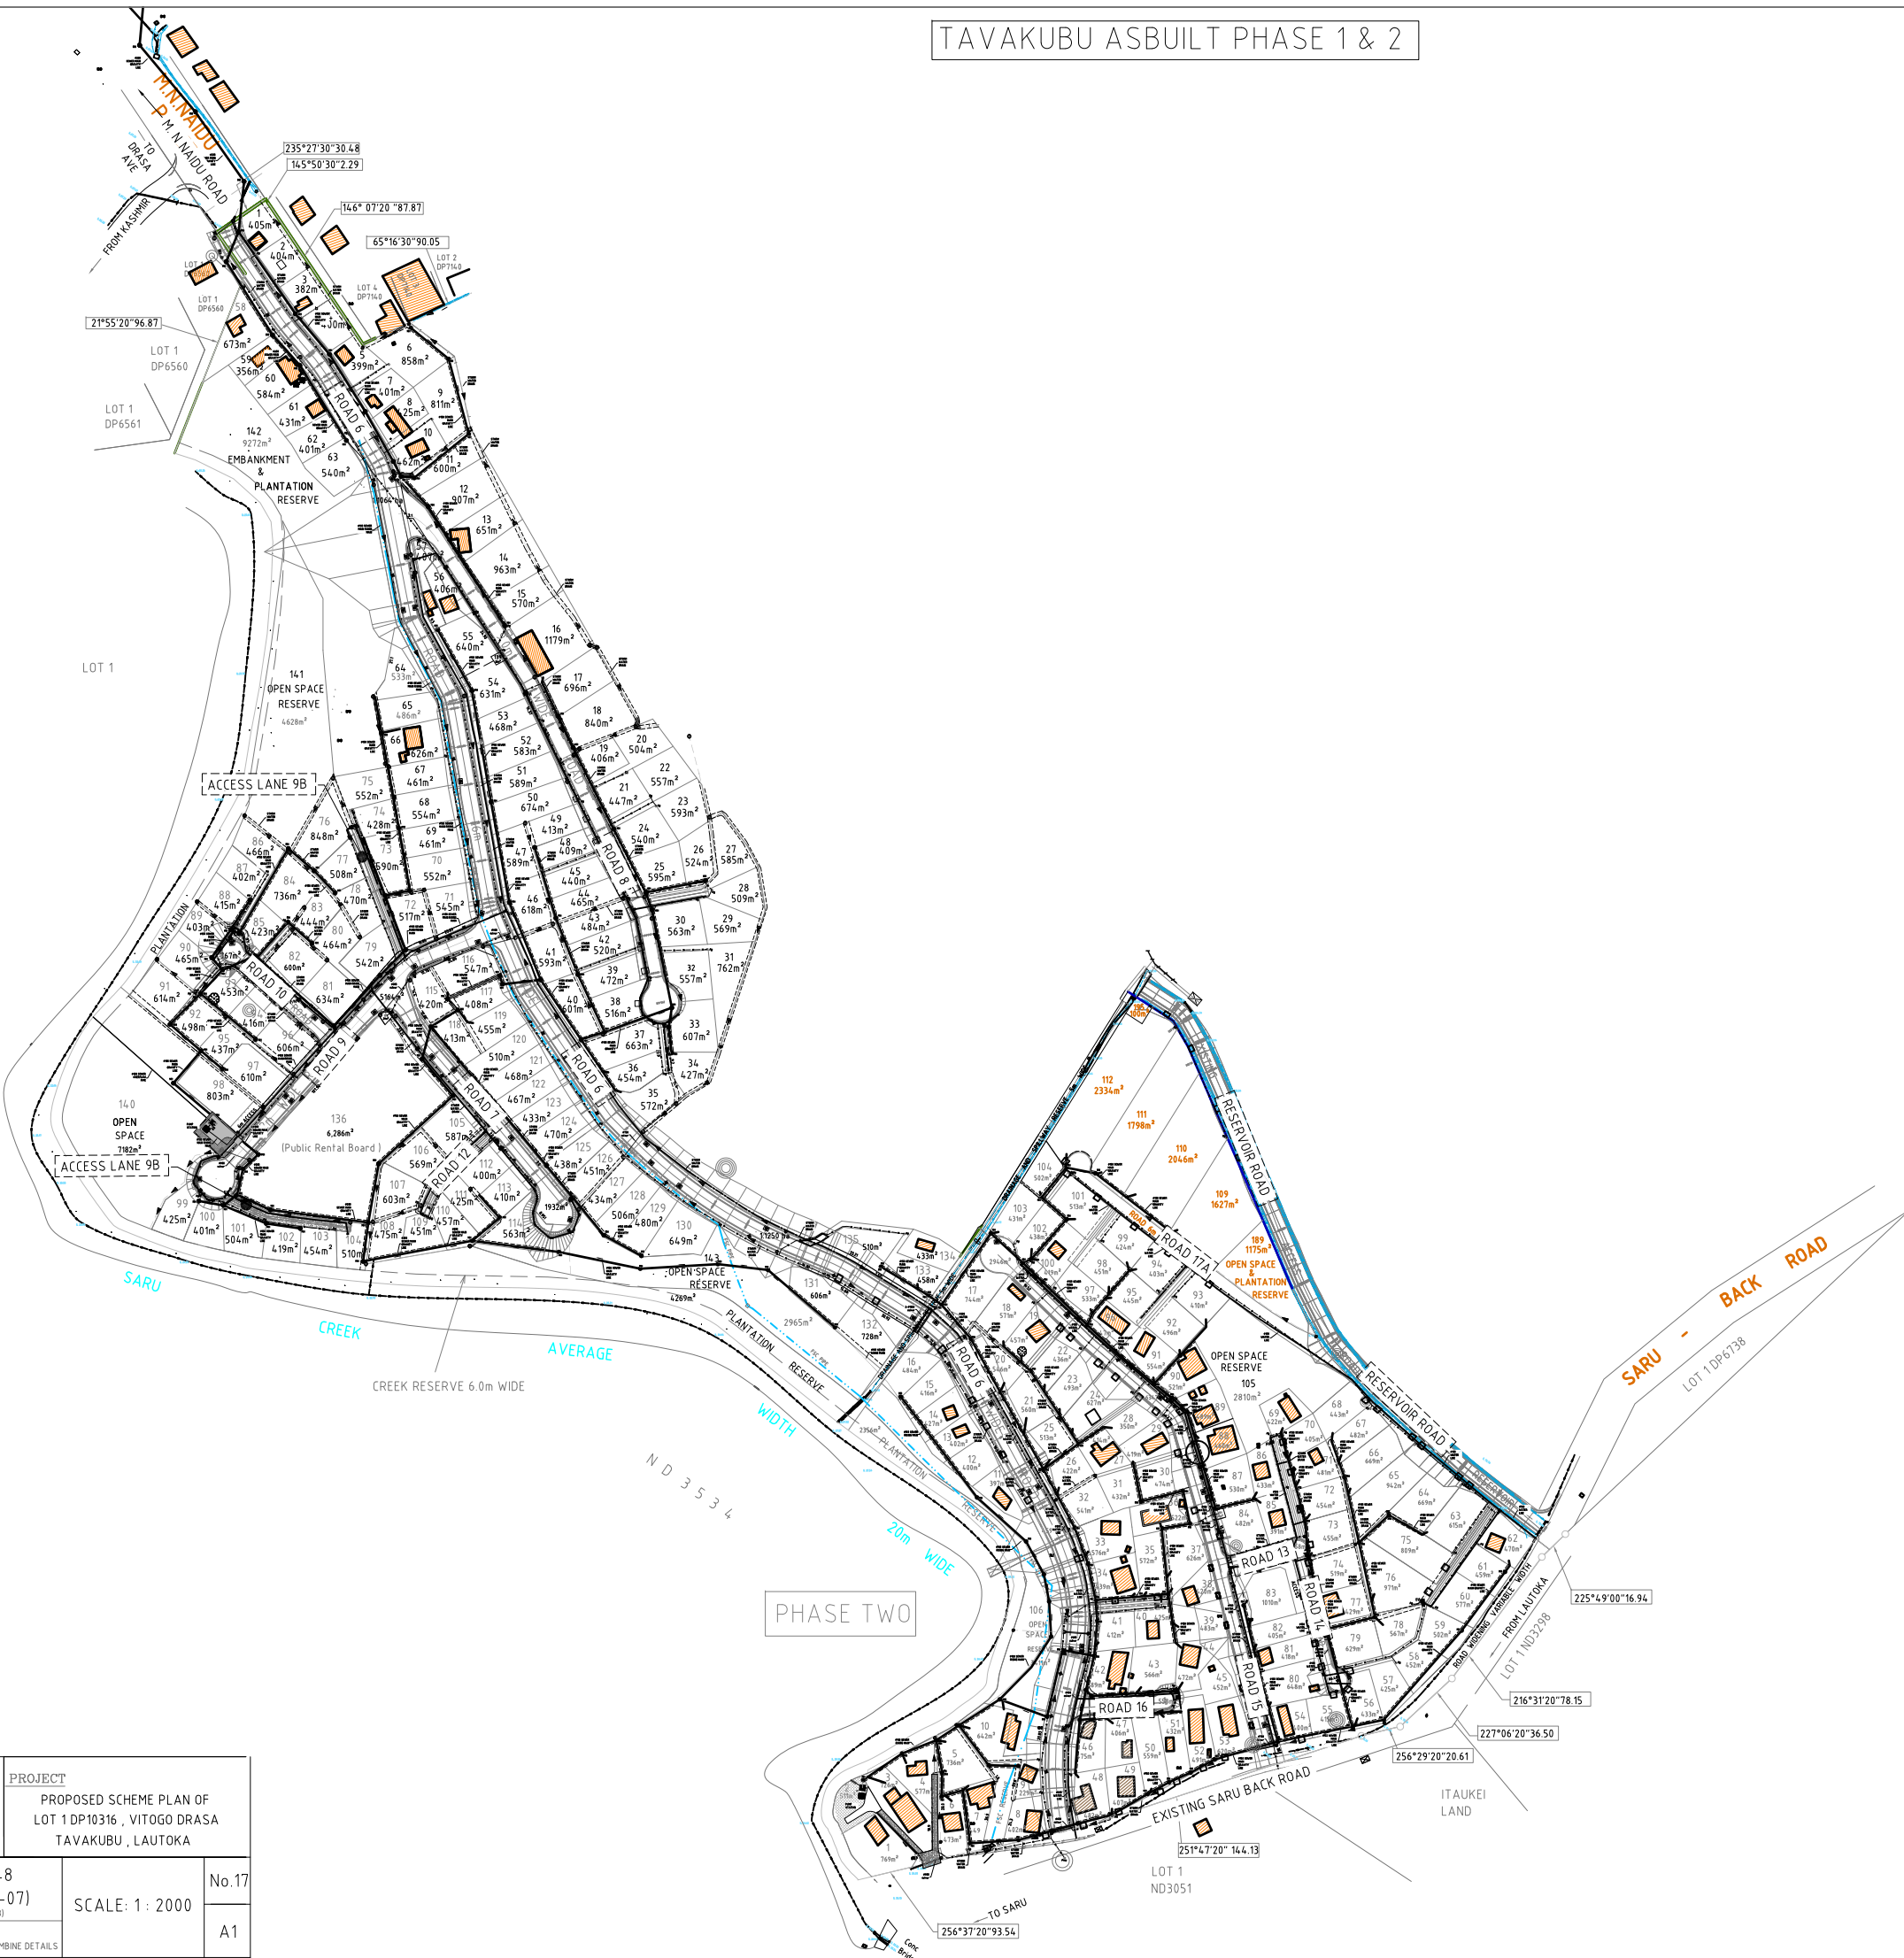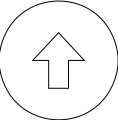

PHASE ONE

PHASE TWO

- LEGEND**
- DENOTES 200/150 SEWERLINE
 - MH - DENOTES SEWER MANHOLE
 - PB - DENOTES PILLAR BOXES
 - DENOTES UNDER ELECTRICAL CABLE
 - DENOTES φ200mm WATER PIPE
 - DENOTES φ150mm WATER PIPE
 - DENOTES φ100mm WATER PIPE
 - ◇ DENOTES DRIVEWAY
 - DENOTES SUMP PITS
 - ★ DENOTES STREET LIGHT
 - DENOTES FIRE HYDRANT

CADASTRALS		PROJECT	
CONSULTING SURVEYORS PLANNERS & PROJECT MANAGERS P. O. BOX 7555, LAUTOKA, PHONE : 6660988, 6660274 FAX 6662447 12 MALOLO STREET, Email : cadsurvey01@gmail.com		PROPOSED SCHEME PLAN OF LOT 1 DP10316, VITOGO DRASA TAVAKUBU, LAUTOKA	
PRINCIPAL CONSULTANTS WesEng Consulting Limited CONSULTING CIVIL/STRUCTURAL ENGINEERS, ENVIRONMENTAL ENGINEERS & PROJECT MANAGERS & GEOTECHNICAL INVESTIGATIONS & TESTING 3 Tai Street, Level 2, A.K.Singh Bldg Lautoka P.O. Box 153 Lautoka, P.O. Box 153 Lautoka, P.O. Box 153 Lautoka Mobile: 9999597, Email: weseng@connect.com.fj	CAD/2148 (2018-REV-07) <small>(06/04/2018)</small>	SCALE: 1: 2000	No.17 A1
ACLT : C/2100-2299/2148-COMBINE DETAILS			